



Assumes North

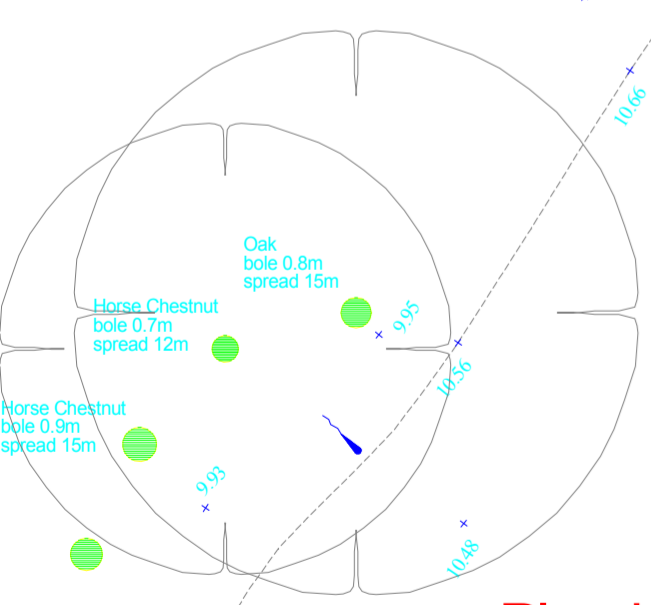

Equipment Key:

- 1. Timber Cradle Swing - SGF*
- 2. Gravity Bowl
- 3. Saturn Bouncer (438) - SGF*
- 4. Play Tractor - SGF*
- 5. Timber (Double Bay) (Team/Flat Seats) Swing - SGF*
- 6. Boogie Woogie Plus (Green) Plastic Slide - SGF*
- 7. Littlebeck Plus (Green) Plastic Slide - SGF*
- 8. Inclusive Orbit (2m) 1S/1H/1W
- 9. Safety Barrier - TGF*
- 10. Timber Intertwine - SGF*
- 11. Timber Twin Balance Beam - SGF*
- 12. Timber Zig Zag Stepper - SGF*
- 13. Timber Cross Beams - SGF*
- 14. Timber Mini Suspension Bridge - SGF*
- 15. Bigland Table
- 16. Rusland Seat
- 17. Concrete Sports Table Tennis Table

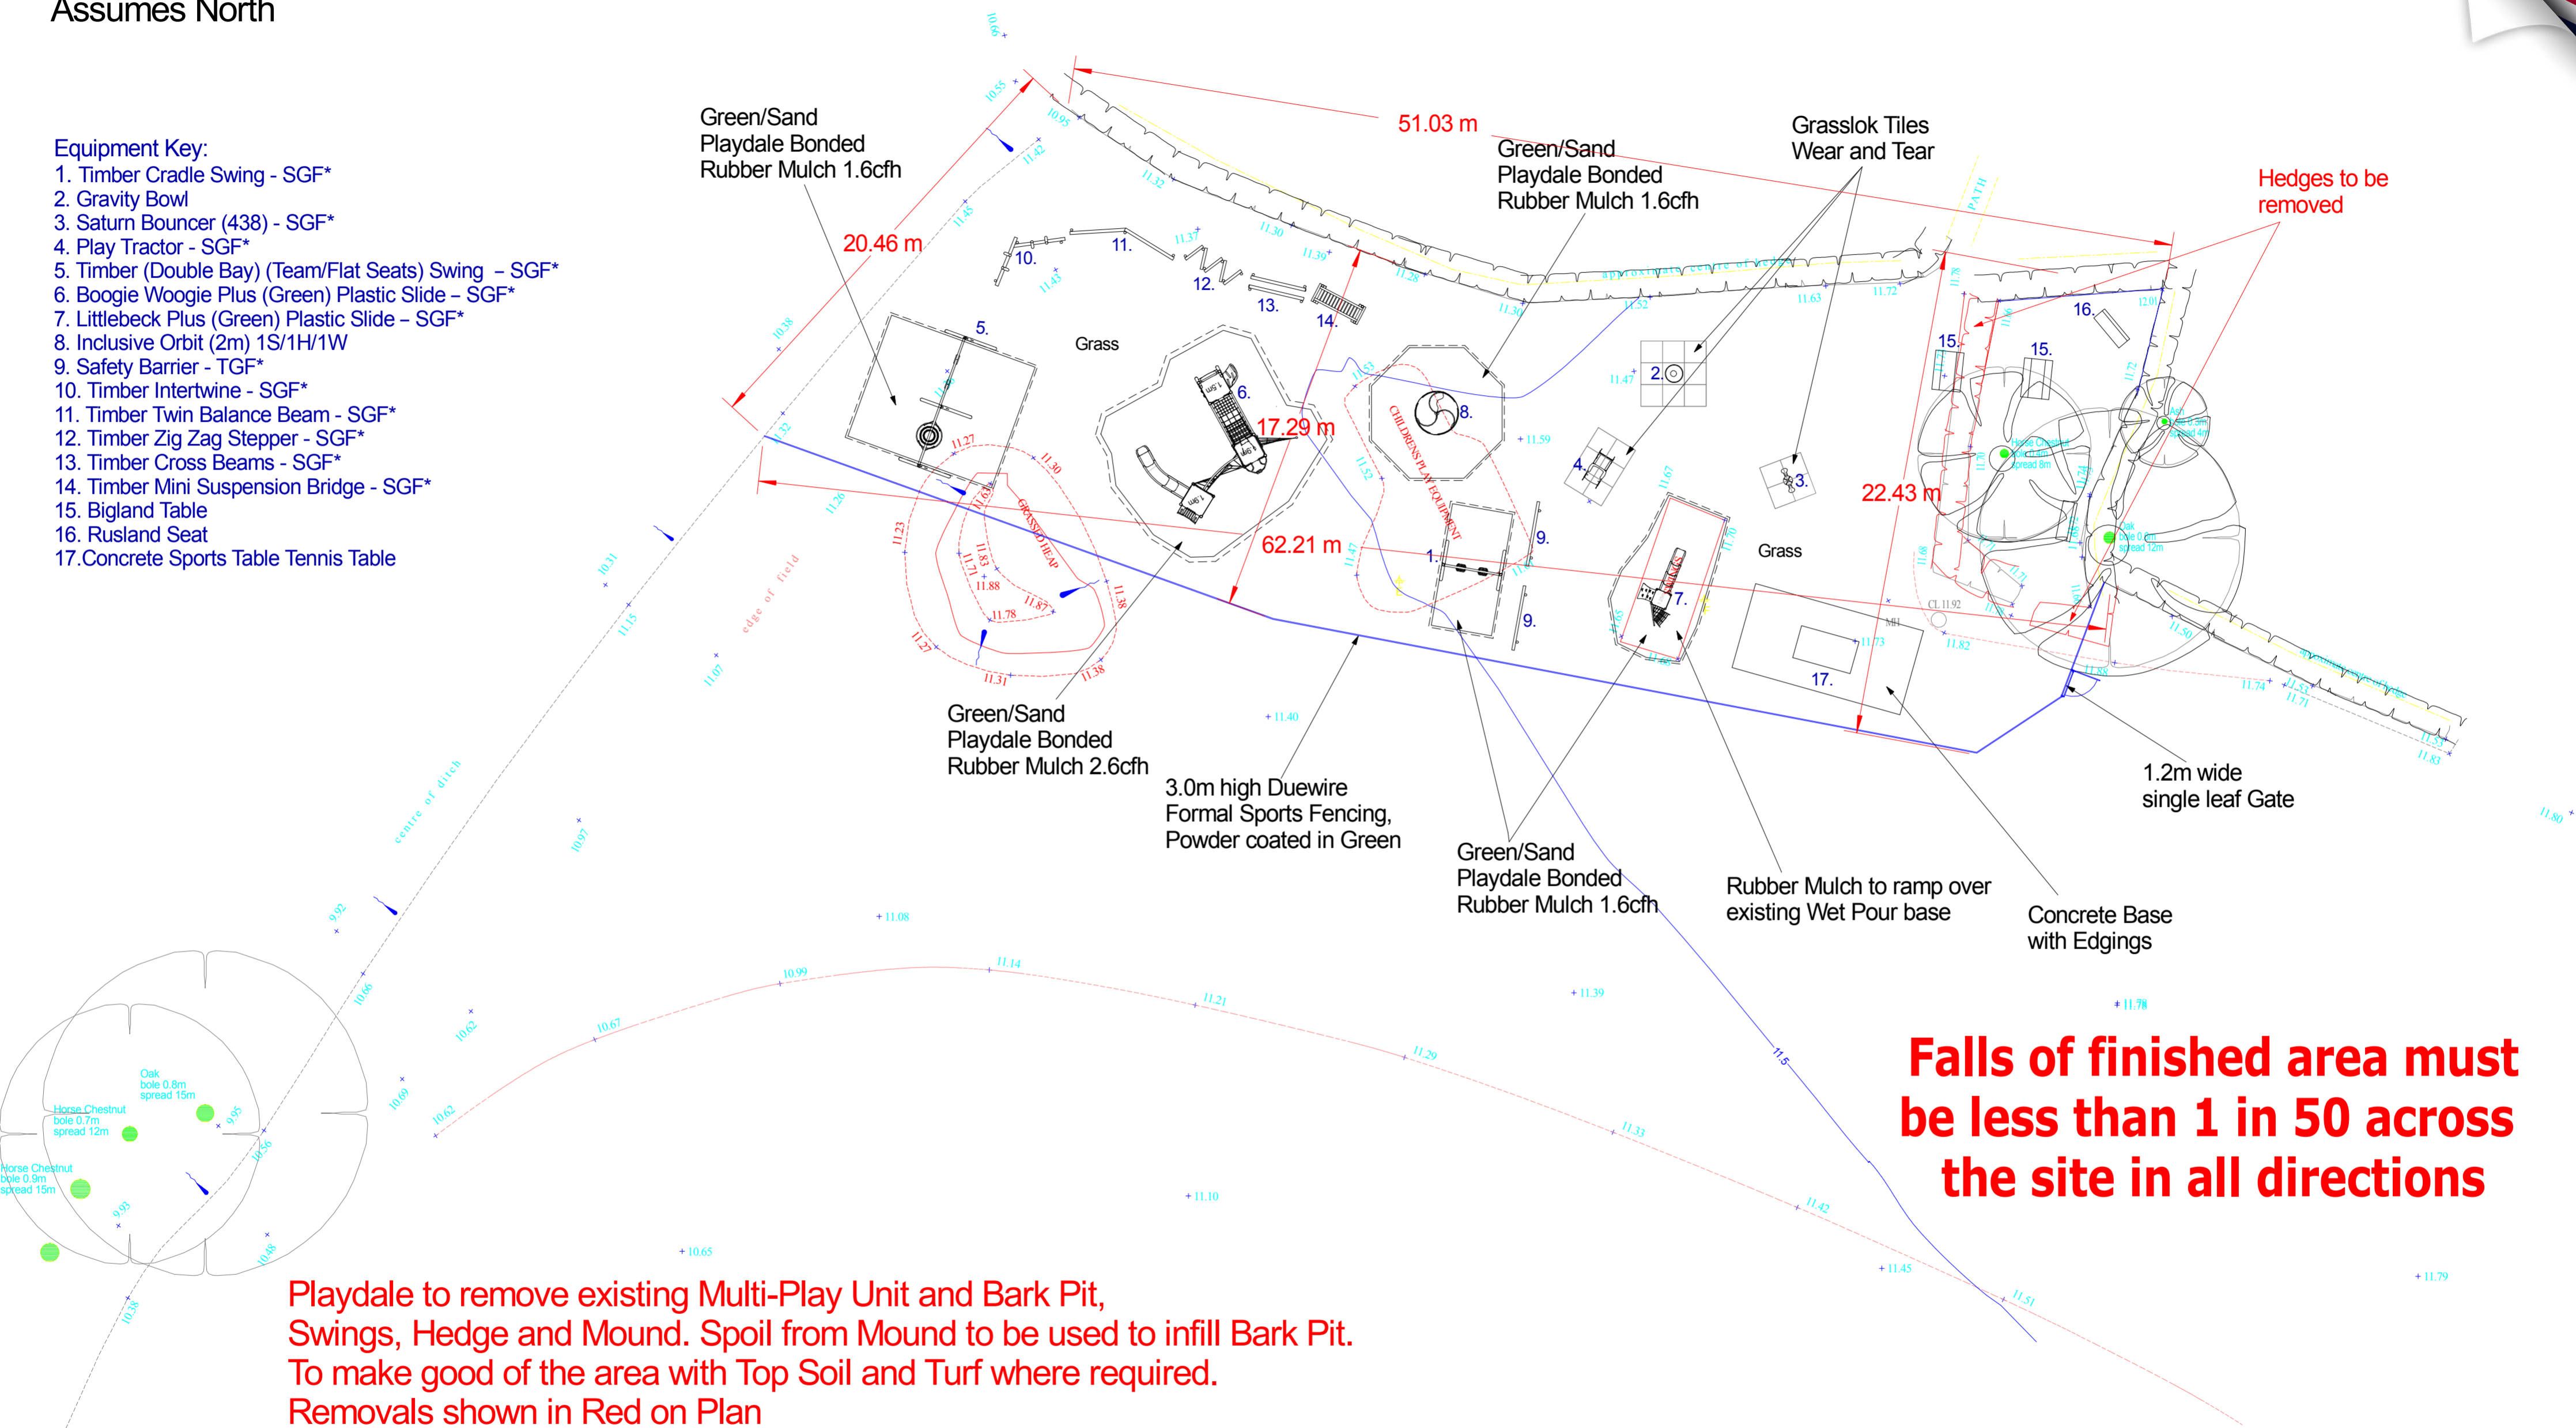

Playdale to remove existing Multi-Play Unit and Bark Pit, Swings, Hedge and Mound. Spoil from Mound to be used to infill Bark Pit. To make good of the area with Top Soil and Turf where required. Removals shown in Red on Plan

Technical Drawing for Isfield Parish Council - Isfield Recreation Ground

Scheme No: 20398rev1-TD01/ESU Date: 02/09/19 Drawn by: KT/AE Scale: 1:200@A2

All plans are to scale unless otherwise stated. Artists impressions are provided as a visual only and may not accurately represent the layout of the finished site. All plans, quotations and correspondence between Playdale and the addressee are to remain strictly confidential between those parties only. Playdale reserve the right to make modification in design and specification.



www.playdale.co.uk

